


Public Domain

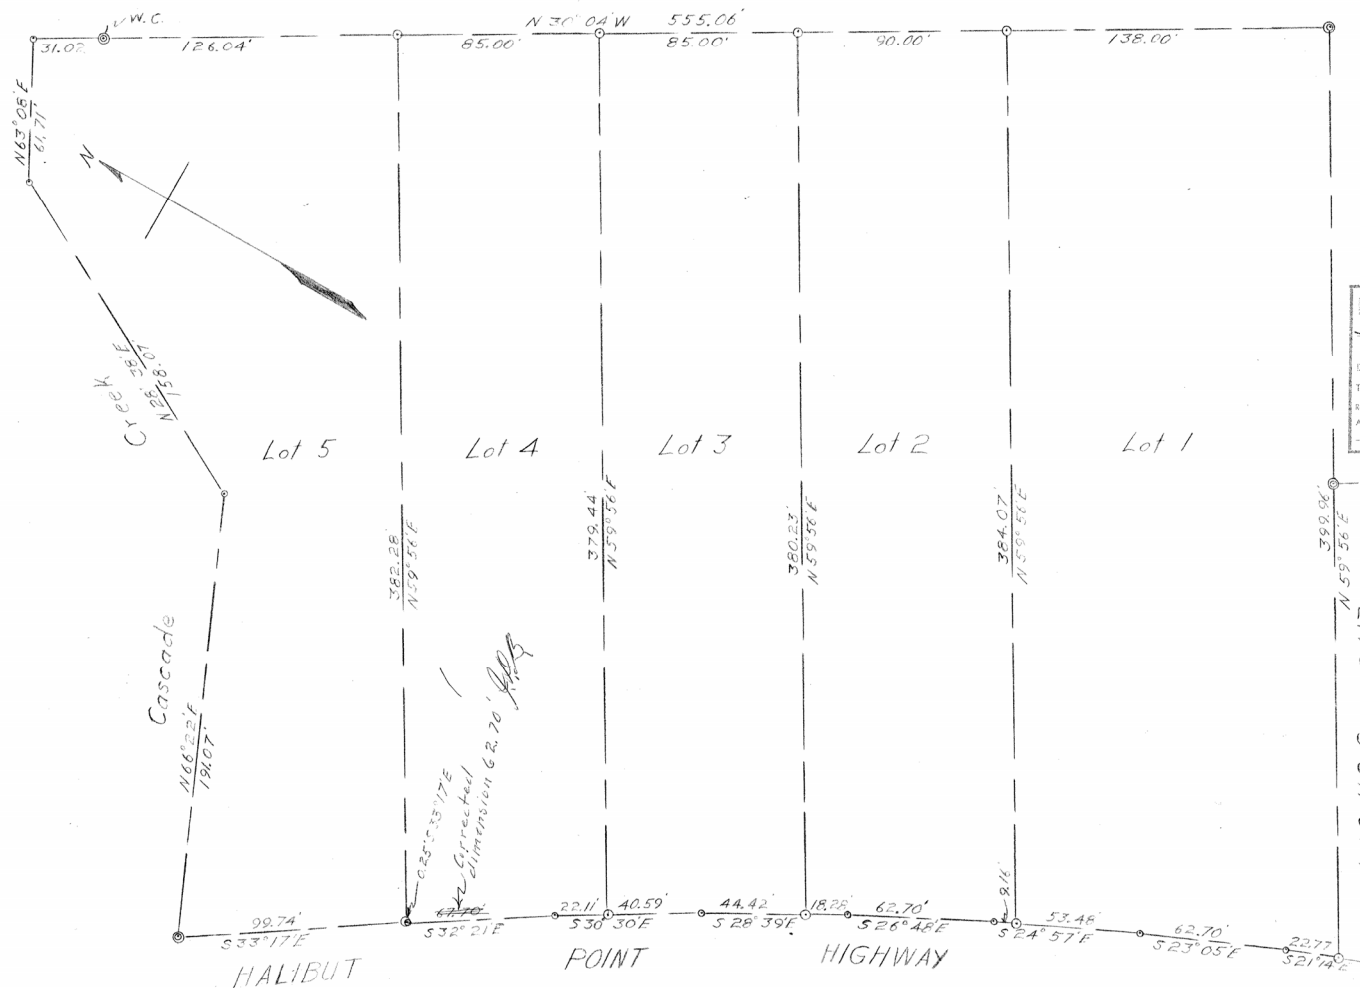

CERTIFICATE OF OWNERSHIP

I (We) hereby CERTIFY that I am (We are) the owner(s) of the property shown and described hereon and that I (We) hereby adopt this plan of subdivision with My (Our) free consent.

Date Nov. 15, 1961 Owner Yuleseeslin
W. Trust William W. Thuis
~~owner~~ Sitka Recorder
Witness _____

RECORDED - FILED	REC. DIST.
<u>Sitka</u>	
DATE <u>11-15-61</u>	
TIME <u>4:20 P.M.</u>	
Requested by <u>Sitka</u>	
Address <u>Alaska</u>	

Notary William W. Thuis
Sitka, Alaska

SITKA
Serial No. 61-679

CERTIFICATE OF REGISTERED ENGINEER


I hereby CERTIFY that I am a Registered Professional Engineer and that this Plat represents the survey made by me, and the monuments shown actually exist as located, and that all dimensional and other details are correct.

Date _____

John E. Ballard

Legend

- B.L.M. Brass Caps
- 2" X 2" X 30" Wood Stakes
- Angle Points not monumented

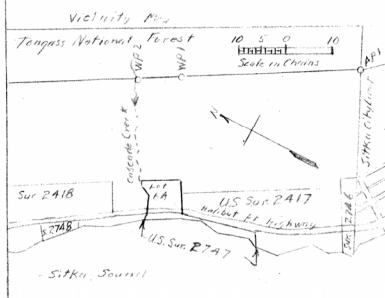

Note: No Platting Board Established

Surveyed Oct 7 - 1960

Scale 1" = 40'

Drawer #1

No. 19

File # 19

Subdivision of Lot 6
at S.S. # 2747
on Halibut Point Highway
Fred Geeslin

Filed 11-15-61

File # 19

Subdivision of Lot 6
at S.S. # ~~27~~ 2747
on Halibut Point Highway
Fred Geeslin

Filed 11-15-61