




FILED AT SITKA, ALASKA THIS 28TH DAY OF SEPT. 1988

STEAGIER
ENGINEERING SERVICES
504 DeGROFF SITKA, AK 99835
(907) 747-5833

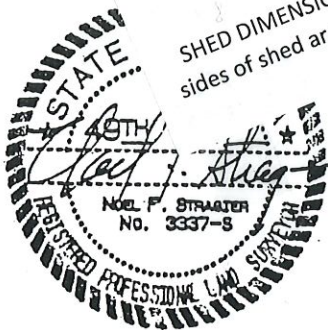

P N D
ENGINEERS, INC.
1440 CLACIER AVE. #101
JUNEAU, AK 99801
907-586-1371
FAX 907-463-5544
mvv@mvvarchitects.com

MRV ARCHITECTS
1420 CLACIER AVE. #101
JUNEAU, AK 99801
907-586-1371
FAX 907-463-5544
mvv@mvvarchitects.com

1622

SAFV RENOVATION & EXPANSION

CONSTRUCTION DOCUMENTS
for
Sikans Against Family Violence


No.	Description	Date

SHEET TITLE:
SITE PLAN

DATE: 4/18/19
SCALE: DND
DRAWN: CMG
CHECKED: CMG
SHEET NO.

C200

NOTE: 11"x 17" PRINT IS HALF SIZE

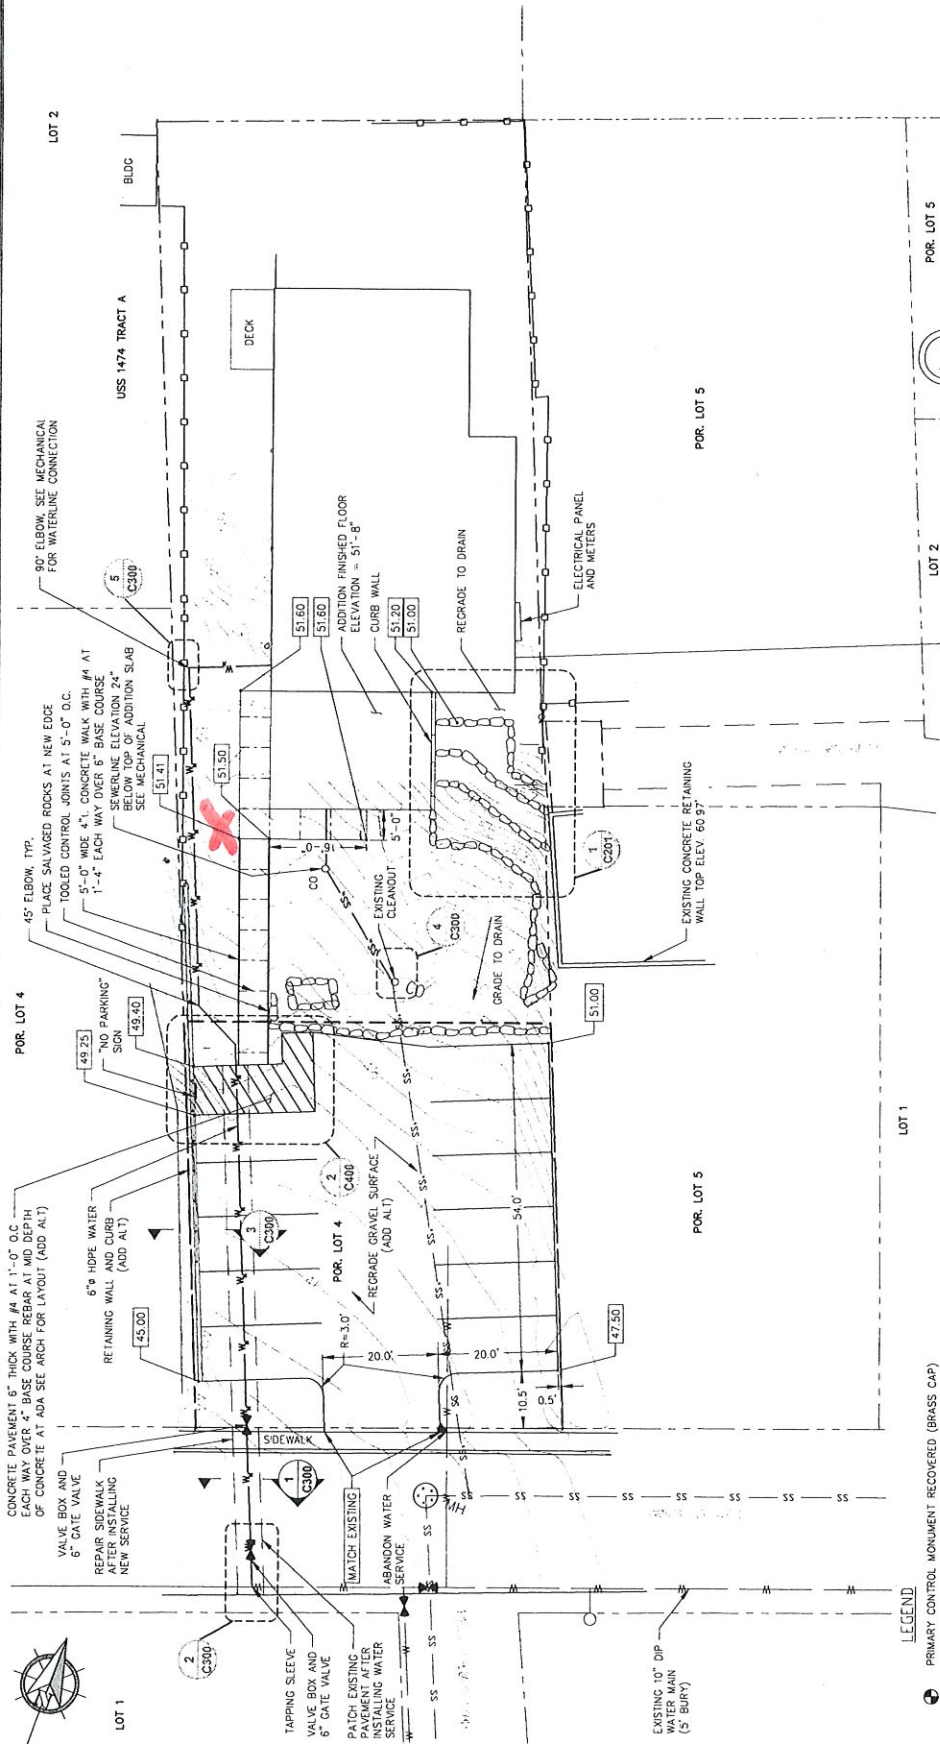

1 SITE PLAN
SCALE IN FEET
0 10 20 FT.

- LEGEND**
- PRIMARY CONTROL MONUMENT RECOVERED (BRASS CAP)
 - BLV/CLO PRIMARY BRASS CAP (RECOVERED)
 - IRON PIPE (RECOVERED)
 - SECONDARY MONUMENT (RECOVERED)
 - RECORDED DATA
 - COMPUTED DATA
 - MEASURED DATA
 - SEWER CLEANOUT
 - MANHOLE
 - POWER POLE
 - FENCE
 - SEWER
 - EXISTING SEWER
 - WATER MAIN
 - WATER SERVICE
 - FINISHED GRADE ELEVATION
 - GRADE BREAK
 - SURFACE DRAINAGE FLOW DIRECTION

* Approx
Location of Shed - See As-Built
Site Plan