



RYAN M. WILSON, PE
PO BOX 414
SITKA, AK 99835
(907) 738-0550

DESIGN
DS OUTHEAST

PROJECT :
PRESTON HOUSE
PROJECT LOCATION:
CASCADE CREEK ROAD


REVISED 12-18-2012
REVISED 1-1-2014

DESIGN RYW
DRAWN RYW

PROJECT No.
S201214

SHEET NUMBER

3 OF 7 SHEETS

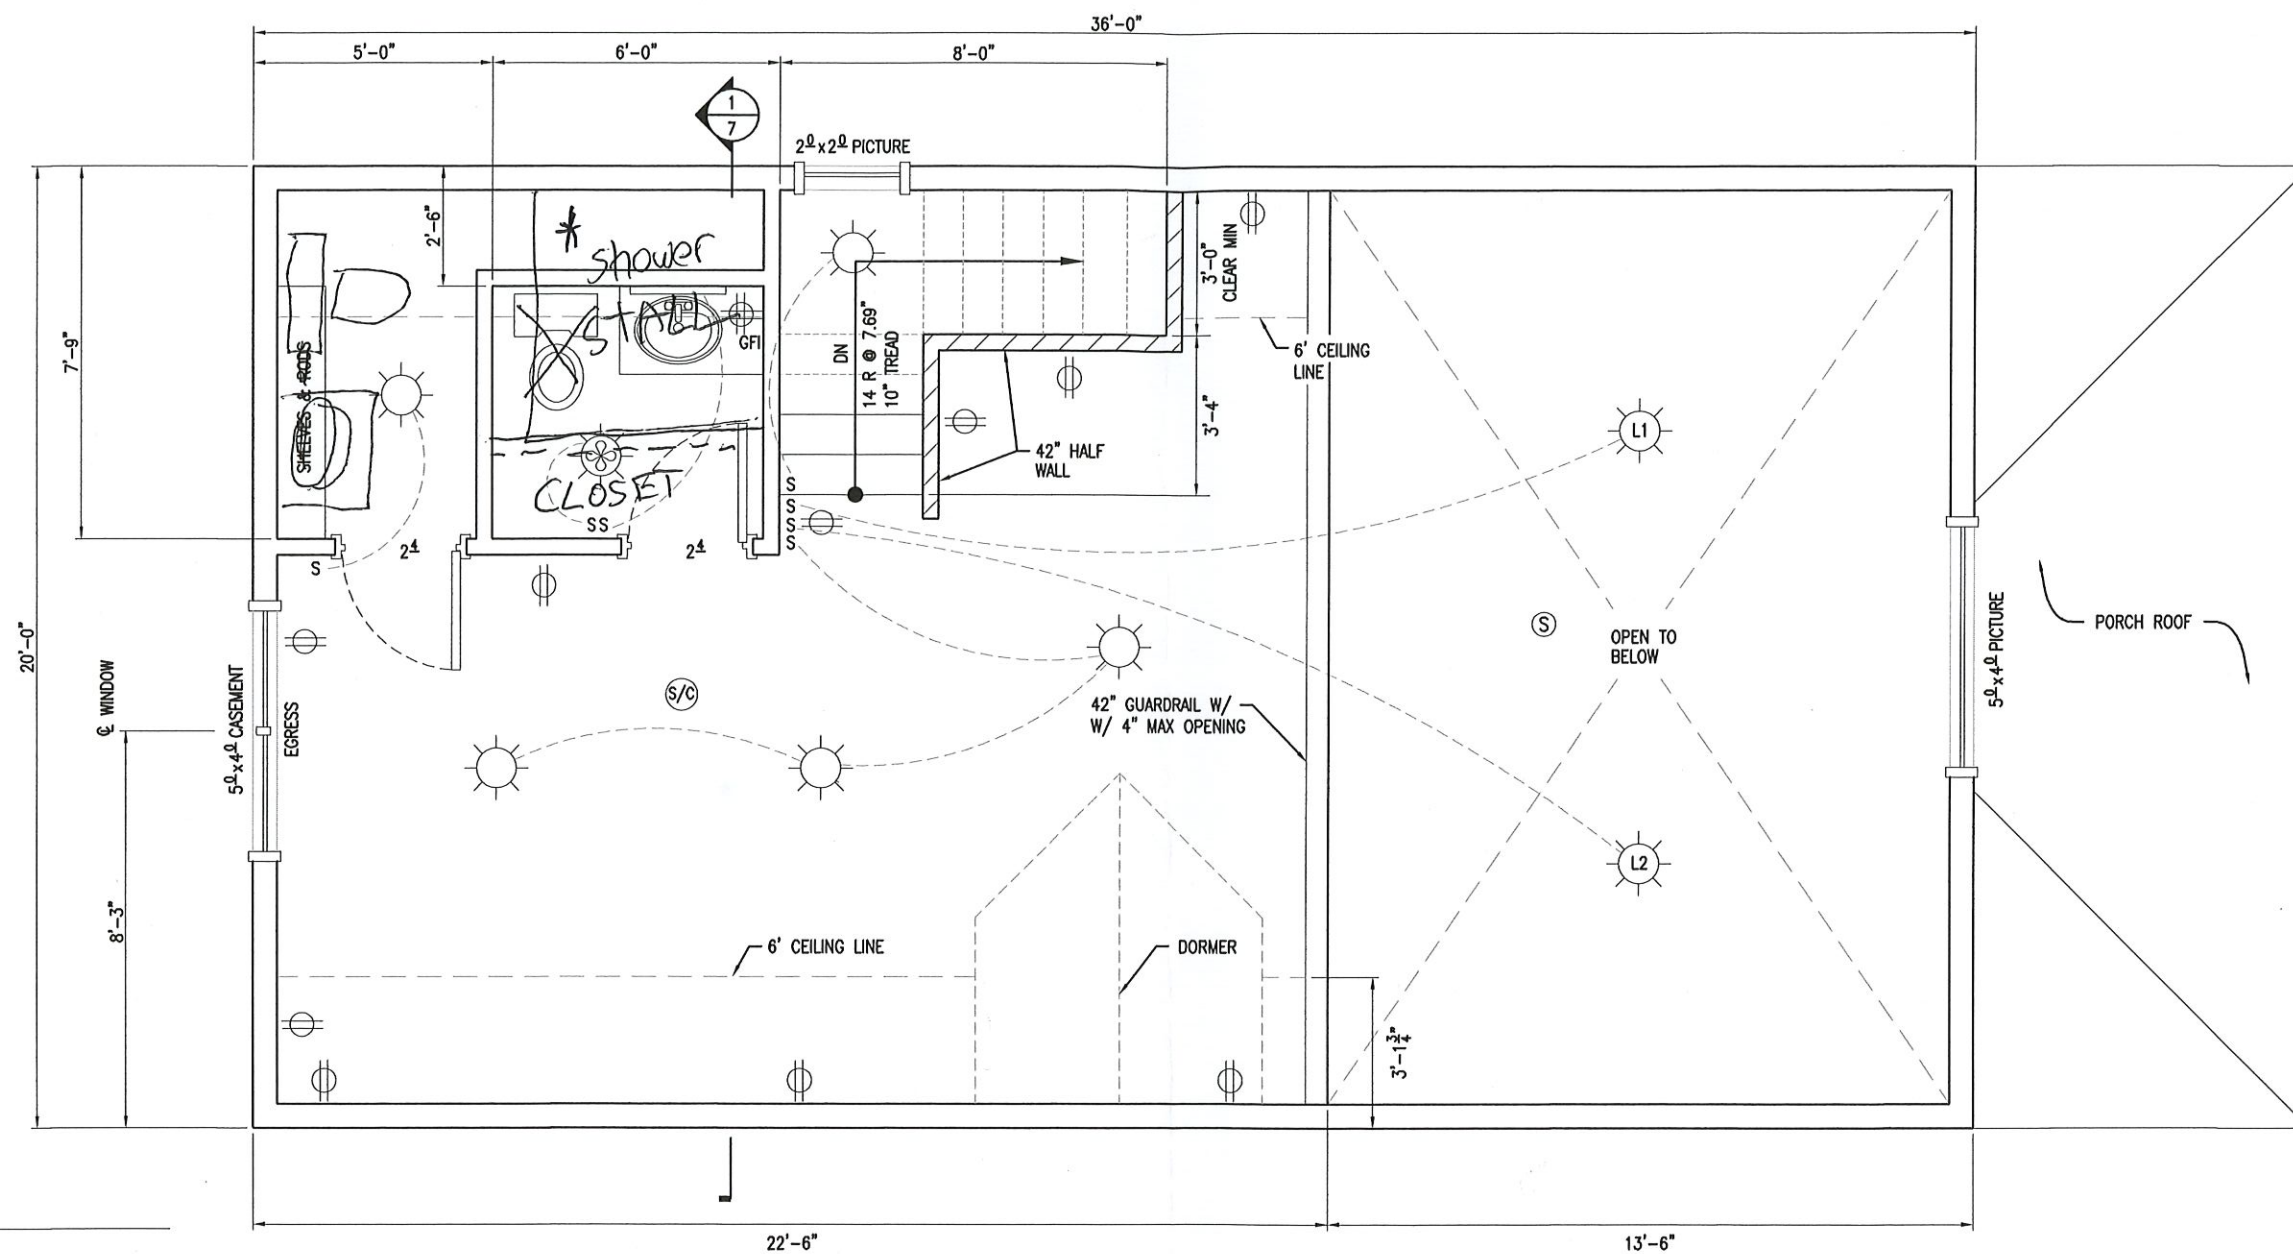

LEGEND

- LIGHT FIXTURE
- BATHROOM LIGHT / EXHAUST FAN COMBO
- NEW SMOKE DETECTOR
- NEW SMOKE & CARBON MONOXIDE DETECTOR

SHEET NOTES

1. EACH BEDROOM ELECTRICAL CIRCUIT TO BE PROTECTED BY AN ARC FAULT BREAKER IN THE SERVICE PANEL.
2. OUTLETS IN THE BATHROOM, KITCHEN AND EXTERIOR TO BE GFI PROTECTED.
3. ALL SMOKE DETECTORS TO BE HARD WIRED, INTERCONNECTED WITH A BATTERY BACKUP.
4. BATHROOM AND COOK STOVE EXHAUST FAN TO BE DUCTED TO THE OUTSIDE WITH RIGID METAL DUCTING.

1 LOFT PLAN
1/4" = 1'-0"

* upstairs bathroom different than depicted in original plans.
As built, full bath w/ shower stall.
Closet facing upstairs bedroom.