


EDGECUMBE DR.

LOT 7A

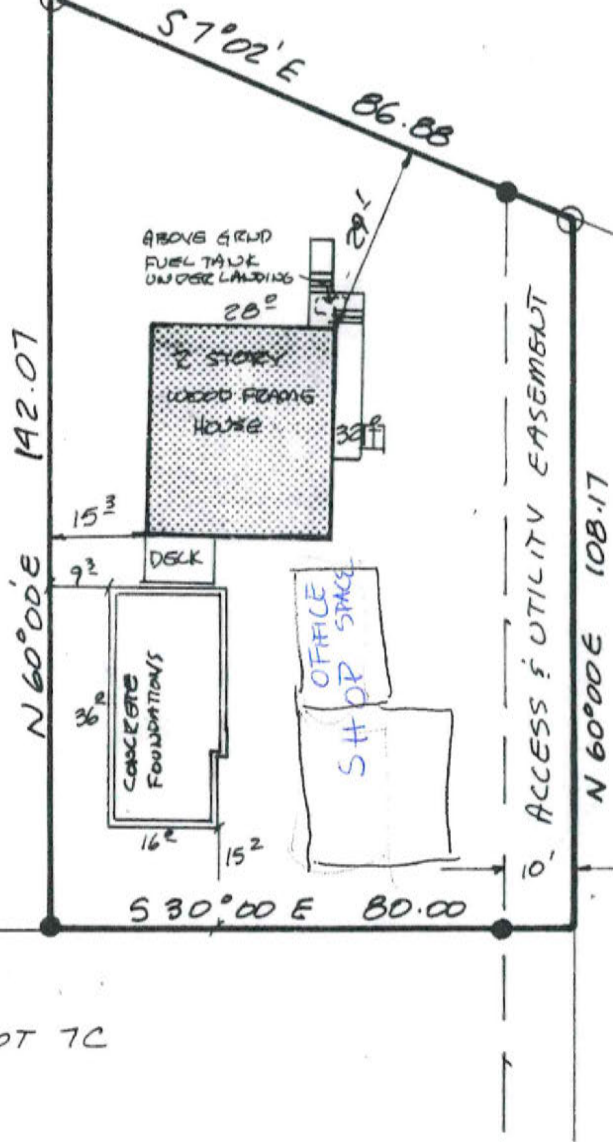

LOT 1

LOT 7C



I hereby certify that I have inspected the following described property: LOT 7B
BODDY SUBDIVISION Sitka Recording District, Alaska, and that the improvements situated thereon are within the property lines and do not overlap or encroach on the property adjacent thereto, that no improvements on the property lying adjacent thereto encroach on the premises in question and that there are no roadways, transmission lines or other visible easements on said property, except as noted hereon.
 It is the owner's responsibility to determine the existence of any easements, covenants, or restrictions which do not appear on the recorded subdivision plat. Under no circumstances should any data shown hereon be used for construction or for establishing boundary or fence lines. Dated at Sitka, Alaska this ____ day of ____ 1993.
Paul F. Stragier, Surveyor

AS-BUILT PLOT PLAN
 LOT 7B
 BODDY SUBDIVISION



STRAGIER
 ENGINEERING SERVICES, INC.
 504 DeGroff St.
 SITKA, ALASKA 99835
 (907) 747-5833

AS-BUILT PLOT PLAN
 Scale 1" = 30'
 Job No. 1454
 Date 3/15/93
 Field Book B7-45

PREPARED FOR:
 MR & MRS. DON KORPELA
 1729 EDGECUMBE DRIVE
 SITKA, ALASKA 99835