

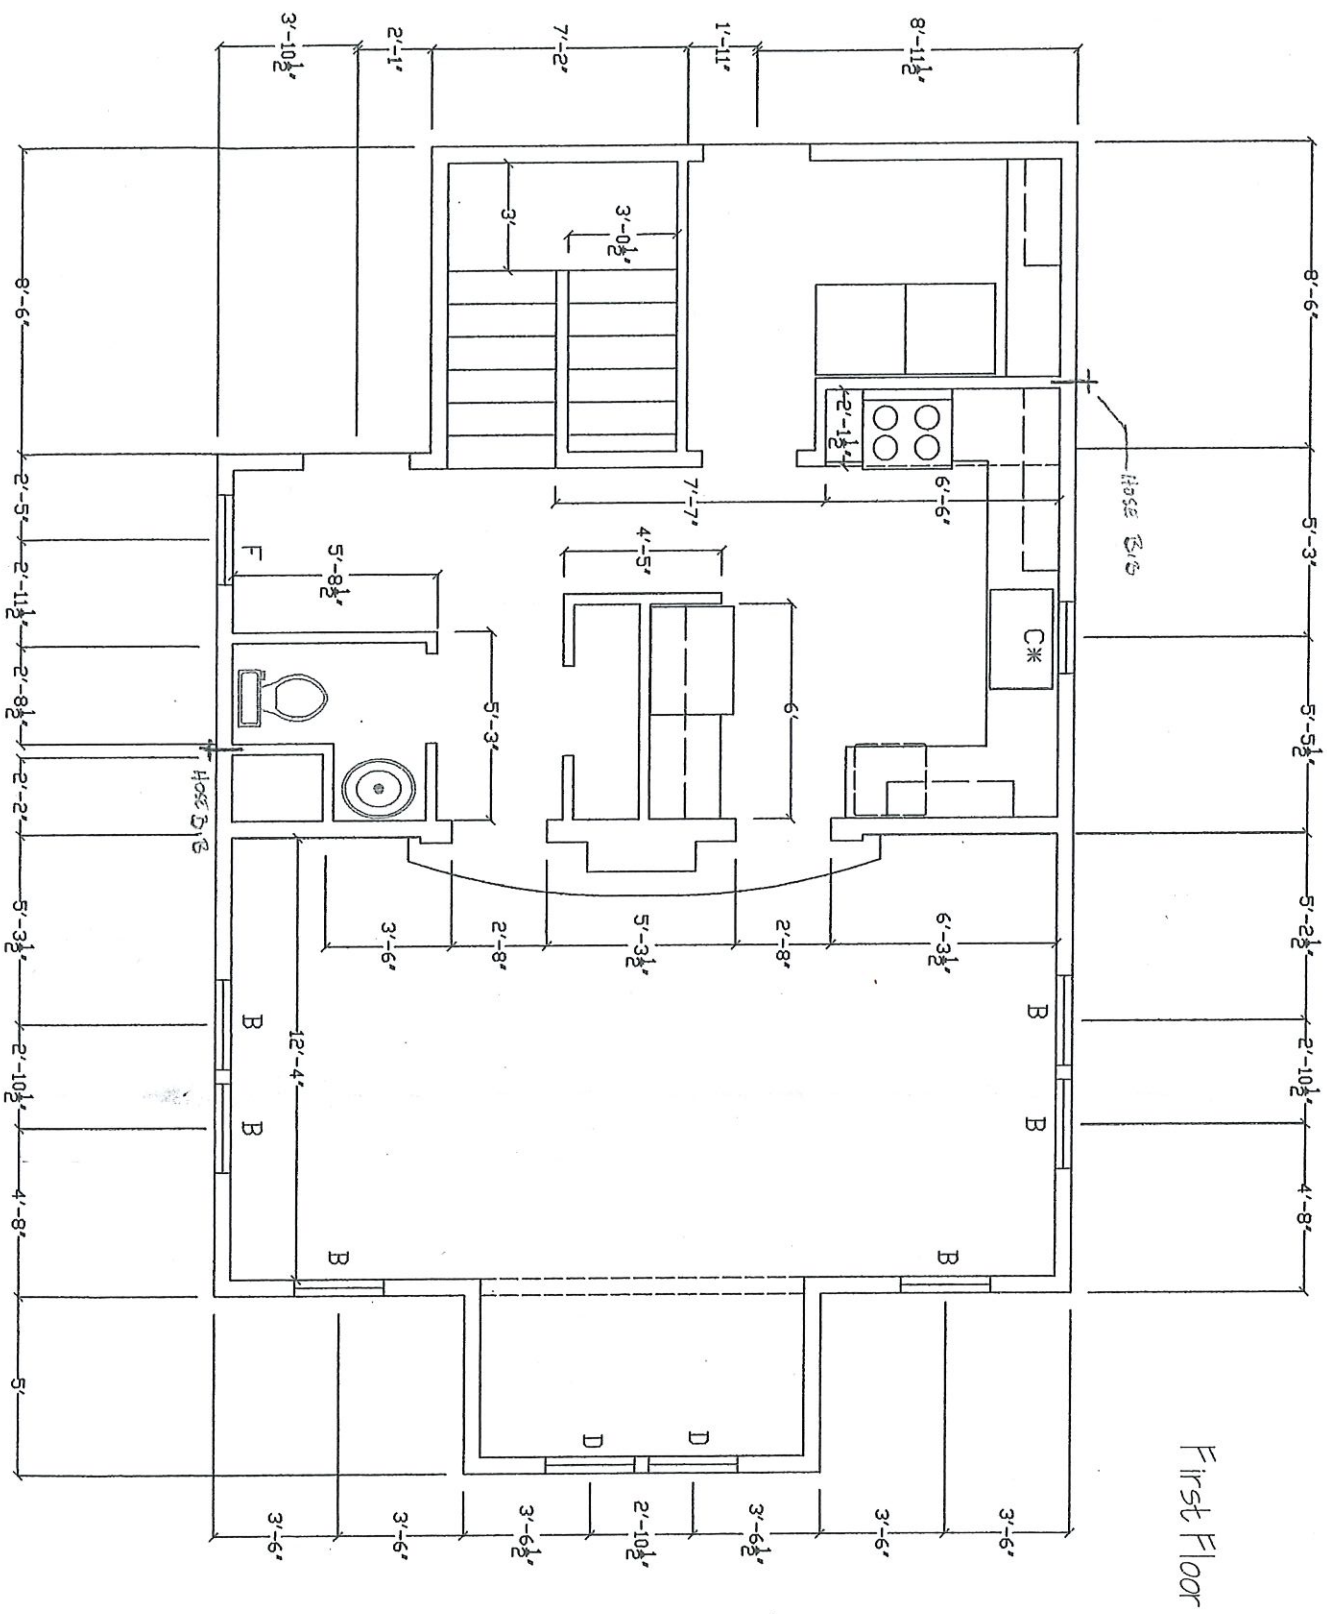



CHAMBERS - 102 LANCE DRIVE

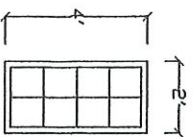


First Floor

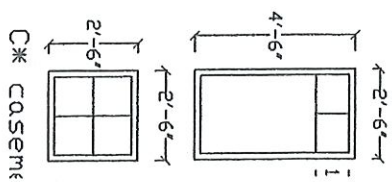

CHAMBERS - 102 LANCE DRIVE

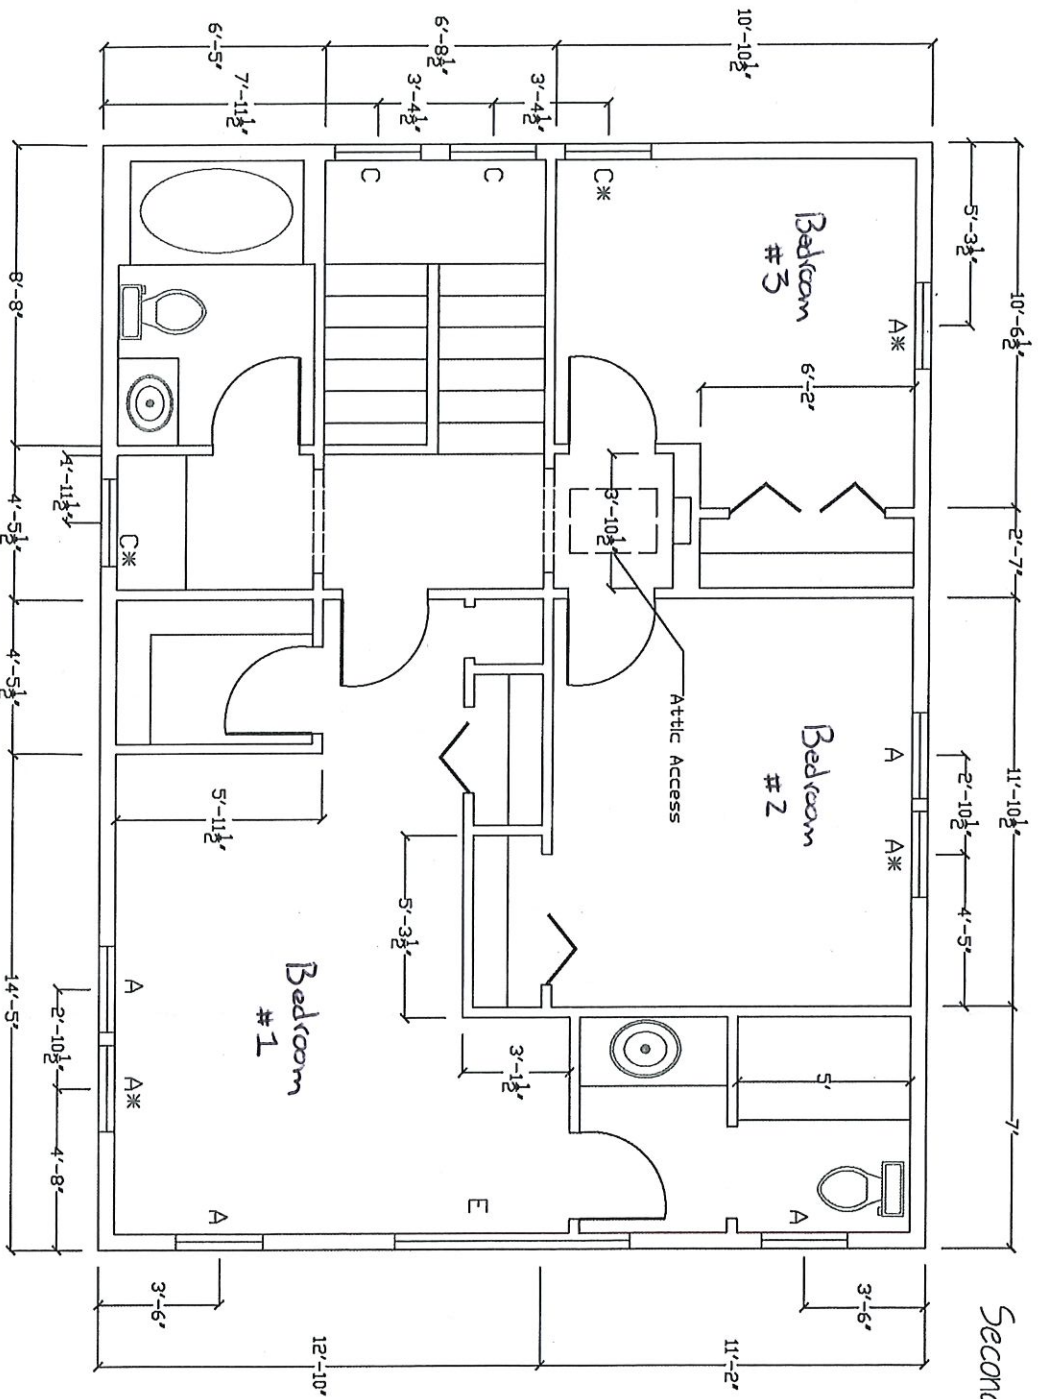

Second Floor

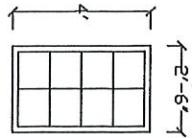

A* casement egress

C* casement

DRAWN BY: JCH/ACD
 CHECKED BY: BPD
 DATE PLATTED: 04/19/06
 DATE SURVEYED: 04/17/06
 SCALE: 1" = 20'
 SURVEYOR: PATRICK K. O'NEILL
 PRD: 30306-03

SURVEYOR'S CERTIFICATE
 I HEREBY CERTIFY THAT I HAVE SURVEYED THE PROPERTY DESCRIBED ON THIS PLAT, I DECLARE THAT IMPROVEMENTS AND VISIBLE ENCROACHMENTS HAVE BEEN ESTABLISHED TO THE BEST OF MY PROFESSIONAL KNOWLEDGE AND BELIEF. THIS SURVEY IS FOR THE USE OF LENDING INSTITUTIONS SPECIFICALLY TO SHOW ANY CONFLICTS BETWEEN EXISTING STRUCTURES AND PLATTED LOT LINES OR EASEMENTS. UNDER NO CIRCUMSTANCES SHOULD THE DATA HEREIN BE USED TO VERIFY THAT IMPROVEMENTS SITUATED ON THIS PARCEL MEET ALL SUBDIVISION COVENANTS AND ZONING ORDINANCES. O'NEILL, SET.
 DATE: 4/20/06
 Patrick K. O'Neill
 Patrick K. O'Neill, LS 6304



O'NEILL
 SURVEYING AND ENGINEERING
 P.O. BOX 1849 SITKA, ALASKA 99835
FOUNDATION ONLY
AS-BUILT SURVEY
 LOT 2
 LANCE DRIVE PUD SUBDIVISION

