



LOT 9-A

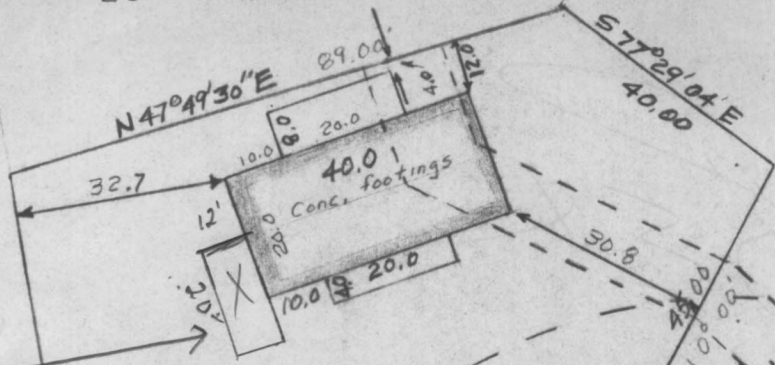

LOT 11-B

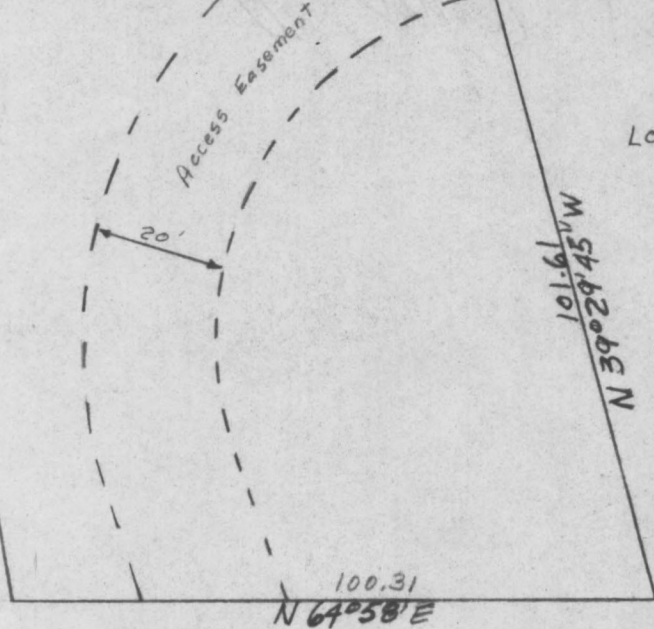

LOT 10

LOT 11-A

30'
Addition



I, NOEL F. STRAGIER, being a Registered Land Surveyor in the State of Alaska, having inspected LOT 11-B Potter Estates, hereby certify that the improvements located thereon lie wholly within the property lines and that improvements on adjacent properties do not encroach upon the subject property.

AS-BUILT PLOT PLAN	
LOT 11-B	
POTTER ESTATES SUBDIVISION	
PREPARED FOR: MR. CLINT POTTER	
Box 1176	
SITKA, ALASKA 99835	
PREPARED BY:	
STRAGIER	
ENGINEERING SERVICES	
P.O. Box 4558 Sitka, Alaska 99835	
(907) 747-5833	
DATE:	April '81