


BABB Parking Spots

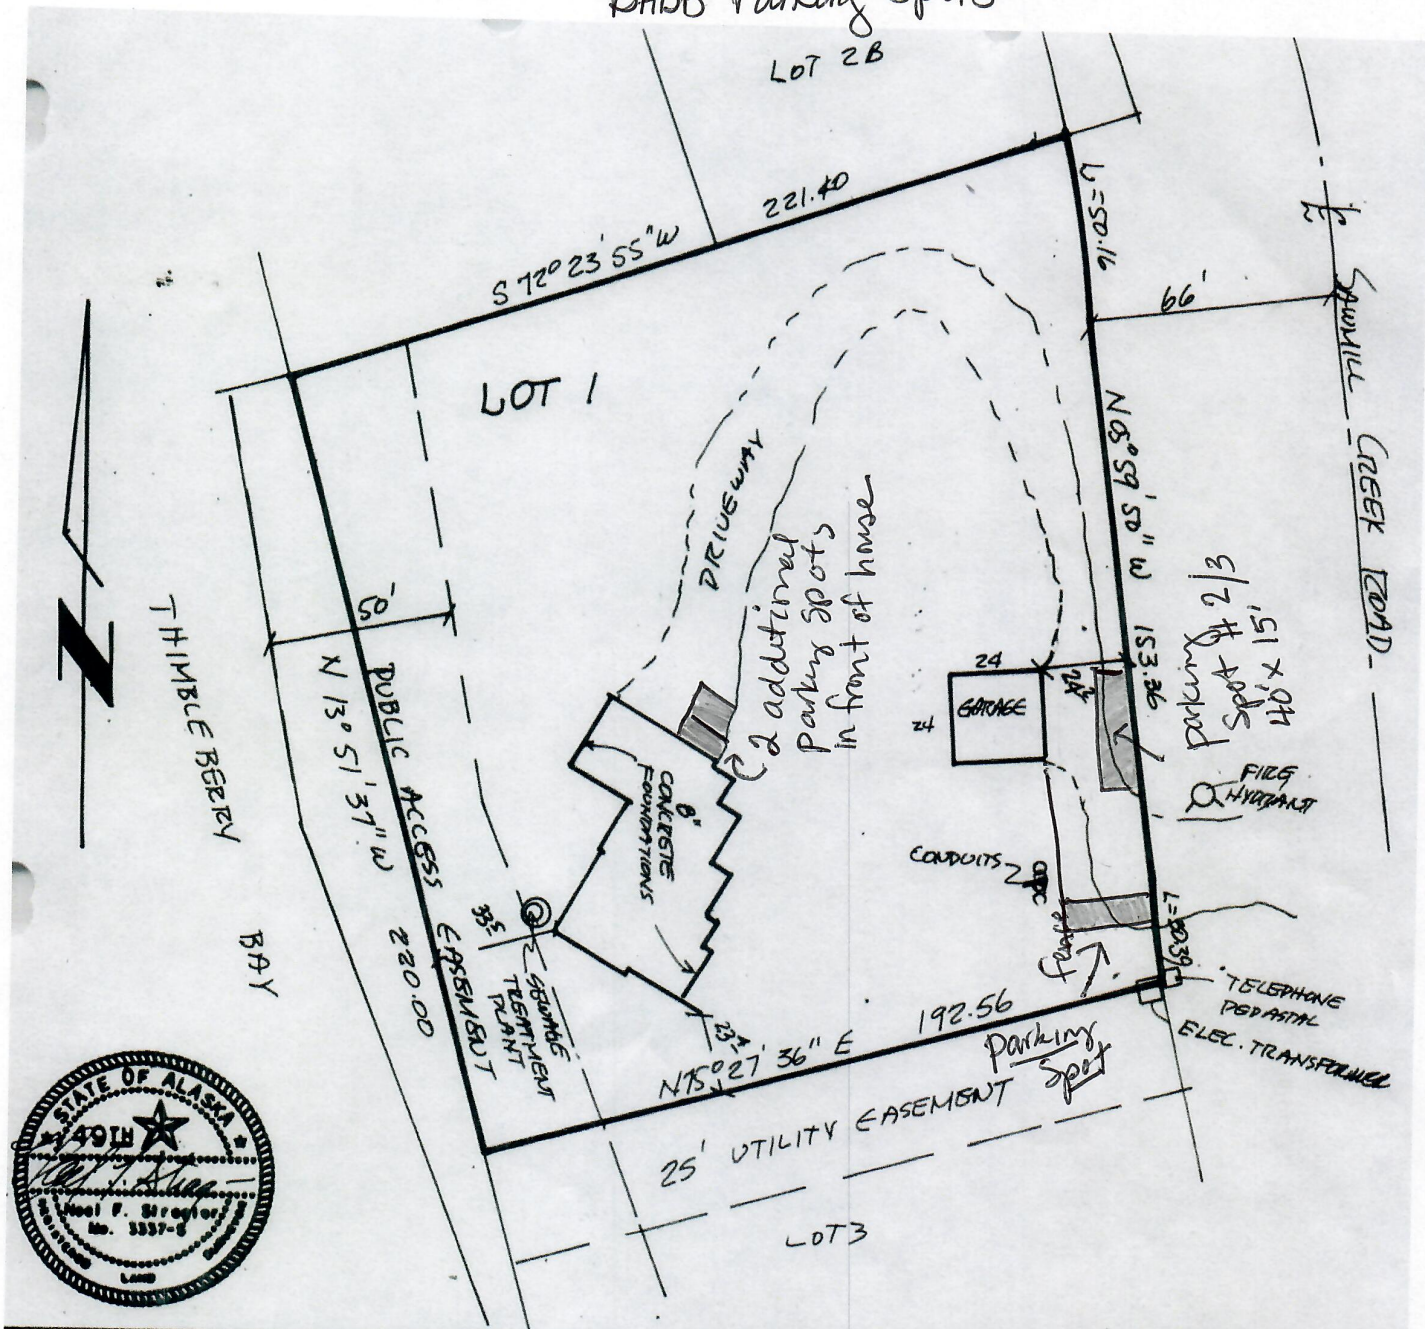

I hereby certify that I have inspected the following described property Lot 1
AMENDED SILVER BAY SUBDIVISION Sitka Recording District, Alaska, and that
the improvements situated thereon are within the property lines and do not en-
croach on the adjacent property, that no improvements on adjacent property
encroach on the subject property and that there are no roadways, transmission
lines or other visible easements on subject property, except as noted hereon.
It is the owner's responsibility to determine the existence of any easements,
covenants or restrictions which do not appear on the recorded subdivision plat.
Under no circumstances should any data shown hereon be used for construction
or for establishment of boundary or fence lines. Dated this 6th day of JULY
1997. Cliff J. Alaga SURVEYOR

AS-BUILT PLOT PLAN

LOT 1
AMENDED SILVER BAY
SUBDIVISION

AS-BUILT PLOT PLAN

Scale 1" = 50'
Job No 21745
Date 7.6.94
Field Book 100-73774

PREPARED FOR
MR. BOB FEHLBERG / KELLER
504 DE GROOT ST.
SITKA, ALASKA 99835



**STRAGIER
ENGINEERING SERVICES**
504 D. GROFF ST
SITKA, ALASKA 99835
907) 747-5833